

Work Order ID 117114

May-23-14 10:12:49 AM

117114

Page 1

Item ID: D2435

D 2435

Accept

N900040100

Setup Start

NS1

Revision ID:

B 117114

Stop

NS2

Item Name: Bearpaw

Start Date: 4/23/14

Start Qty: 13.00

13

Cust Item ID:

Required Date: 4/23/14

Req'd Qty: 13.00

13

Customer:

Reference:

Approvals:

Process Plan:

Date:

Tooling:

Date:

Run Start

NR1

QC:

Date:

SPC (Y/N):

Date:

Stop

NR2

Sequence ID/
Work Center ID

Operation
Description

Set Up/
Run Hours

Tool ID

Tool #

Plan
Code

Accept
Qty

Reject
Qty

Reject
Number

Insp.
Stamp

Draw Nbr

Revision Nbr

D2435

Rev E1

105

0.00

105

Purchasing

Memo

0.00

Purchasing

ISSUE PO

CUT BLANK AS PER FILE D2435

CZ 14/05/26 13

115

Receive & Inspect for Damage & Mat'l Certs

0.00

115

Packaging

Memo

0.00

Packaging

Bx. SP 14-6-10

125

QC6- Inspect dimensions to drawing

0.00

125

QC

Memo

0.00

Quality Control

OZ 14/06/21 13

May-23-14 10:12:49 AM

Page 2

NS1

NS2

Customer:

NR1

NR2

Date:

**Insp.
Stamp**

Quality Control

13 ~~0~~ ~~14/06/19~~

13 ~~1~~ ~~14/06/19~~

14/06/23 13 ~~14~~ ~~15~~ ~~16~~ ~~476~~

Work Order ID 117114

May-23-14 10:12:49 AM

117114

Page 3

Item ID: D2435 Accept ***N900040100*** Setup Start ***NS1***
 Revision ID: Stop ***NS2***
 Item Name: Bearpaw
 Start Date: 4/23/14 Start Qty: 13.00 ***13*** Cust Item ID:
 Required Date: 4/23/14 Req'd Qty: 13.00 ***13*** Customer:
 Reference:

Approvals: Process Plan: _____ Date: _____ Tooling: _____ Date: _____ Run Start ***NR1***
 QC: _____ Date: _____ SPC (Y/N): _____ Date: _____ Stop ***NR2***

Sequence ID/ Work Center ID	Operation Description	Set Up/ Run Hours	Tool ID	Tool #	Plan Code	Accept Qty	Reject Qty	Reject Number	Insp. Stamp
151	Identify as per dwg & Stock Location: _____	0.00							
151									
Packaging	Memo P1115079 100	0.00							
Packaging	B12008730								
190	QC21- Final Inspection - Work Order Release	0.00							
190									
QC	Memo	0.00							
Quality Control									

14/7/2 (13)

MLJ 14-07-02

14-702

Picklist Print

May-23-14 10:12:49 AM

Page 1

Work Order ID: 117114

117114

Parent Item: D2435

D2435

Parent Item Name: Bearpaw

Start Date: 4/23/14

Required Date: 4/23/14

Start Qty: 13.00

Required Qty: 13.00

Comments:

Component Item ID/ Item Name	Replacement Item ID	Mfg/ Purch	Bin Item	Primary Location	Last Location	Route Seq ID	Unit of Measure	Qty on Hand	Qty per Kit	Total Qty	Qty Issued	Date Issued	Status
MUHMWB10		Purchased	No			120	sf	400.0000	3.2	42			

MUHMWB10

UHMW 1" Black - 48"x120" Tivar Mfg.#52480104

**

C214/05/28

Location

Loc Qty

Loc Code

MAT018

400

m128267

47

m128668

353

m129293

DART AEROSPACE LTD		Work Order: 117114
Description: Bearpaw		Part Number: D2435
Inspection Dwg: D2435	Rev: E1	Page 1 of 1

FIRST ARTICLE INSPECTION CHECKLIST

☒ First Article ☐ Prototype

Inspection Sheet	Drawing Dimension	Tolerance	Actual Dimension	Accept	Reject	Method of Inspection	Comments
A	0.063 x 45°	+0.030/-0.010	0.0580	✓		MIP-04	vern
B	5.500	+/-0.030	5.495	✓	
C	0.200	+/-0.030	0.190	✓		GA-02	Dial depth gauge
D	R0.250	+/-0.030	0.250	✓		---	Radius gauge
E	0.250	+/-0.010	0.260	✓		MIP-04	vern
F	0.625	+/-0.030	0.635	✓	
G	0.25 x 45°	+/-0.030	0.260	✓		↓	↓
H	0.375	+/-0.010	0.375	✓		↓	↓
I	19.000	+/-0.030	19.000	✓		MIP-07	Tape
J	0.950	+0.030/-0.010	0.975	✓		MIP-04	vern
K	Ø0.260	+0.005/-0.000	0.260	✓	
L	Ø0.930	+/-0.030	0.930	✓	
M	0.30	+0.030/-0.000	0.310	✓		GA-08	Dial depth gauge
N	0.375	+/-0.030	0.375	✓		MIP-04	vern
O	7.375	+/-0.030	7.366	✓		CNC-02	vern
P	4.250	+/-0.010	4.250	✓		MIP-04	vern
Q	2.000	+/-0.030	2.000	✓	
R	9.000	+/-0.010	9.000	✓		CNC-02	vern
S	15.750	+/-0.030	15.750	✓		MIP-07	Tape

Measured by: <i>[Signature]</i>	Audited by: <i>[Signature]</i>	Prototype Approval: N/A
Date: 14/06/19	Date: 14/06/23	Date:

Rev	Date	Change	Revised by	Approved
A	03.09.22	New Issue P/O K10007	KJ/RF <i>[Signature]</i>	<i>[Signature]</i>




DESIGN KE		DRAWN BY KE		DART AEROSPACE LTD HAWKESBURY, ONTARIO, CANADA	
CHECKED MB		APPROVED JS		DRAWING NO. D2435	
DATE 98.05.19		TITLE BEARPAW		REV. E SHEET 1 OF 2	
A	96.01.24	NEW ISSUE			
B	96.03.26	CHANGE BORE AND C'BORE DEPTH			
C	97.05.07	CHANNEL & C'BORE DEPTH CHANGED			
D	97.10.17	R1.5 BORE WAS R2.637 (TSR A469)			
E	98.05.19	CHANGE C'BORE, R1.58 WAS R1.50			

EFFECTIVE DEOS

RELEASED
99.06.17 KE

ENGRAVE LOGO TO MAX
DEPTH OF 0.012. ENGRAVE
PART AND BATCH NUMBERS
TO MAX DEPTH OF 0.010.
(TYPICAL LOCATION AS
ILLUSTRATED)

62-6041
1404-29
57M
10117114



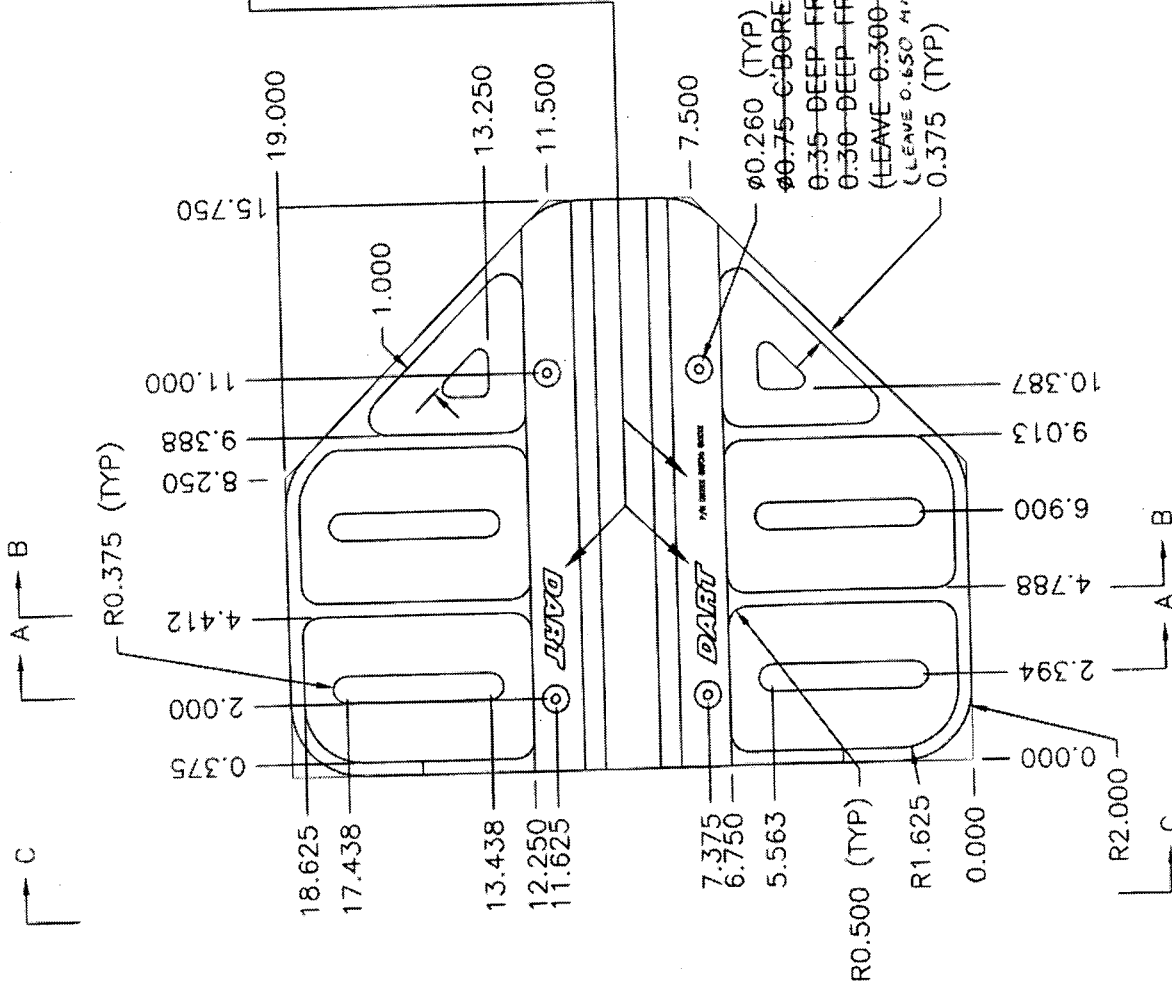


MATERIAL: UHMW BLACK PER SPEC CONTROL DRAWING D2689
1.00 THICK (MACHINE TO 0.950)



DESIGN <i>KE</i>	DRAWN BY <i>KE</i>	DART AEROSPACE LTD HAWKESBURY, ONTARIO, CANADA	
CHECKED <i>MB</i>	APPROVED <i>[Signature]</i>	DRAWING NO. D2435	REV. E SHEET 2 OF 2
DATE 98.05.19		TITLE BEARPAW	SCALE 1:4

RELEASED
98.06.17 KE

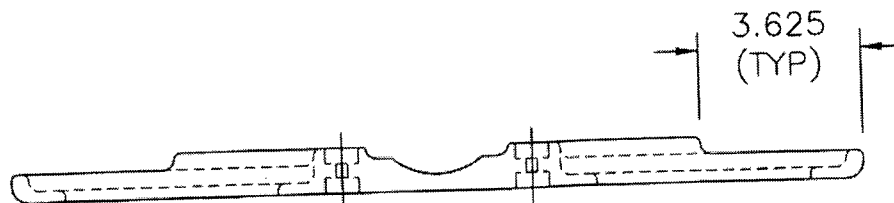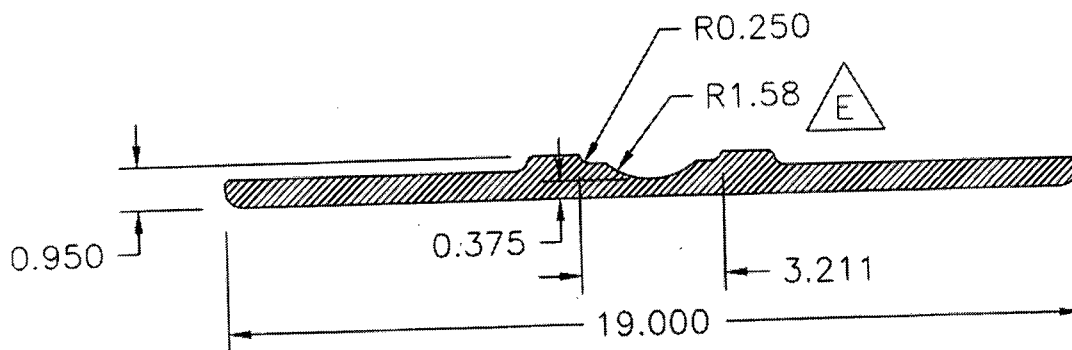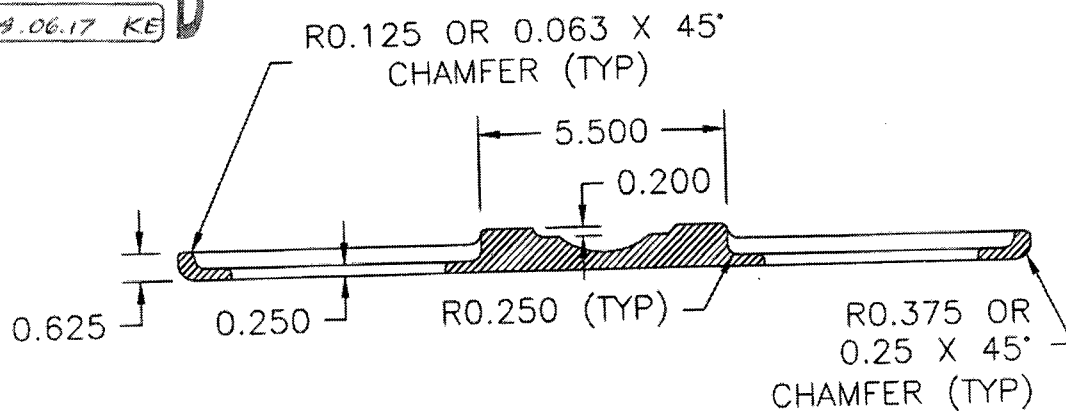



Dart Aerospace Ltd.
1270 Aberdeen Street
Hawkesbury, ON K6A 1K7
Tel: 613 632 9577
Fax: 613 632 1053

PURCHASE ORDER

Purchase Order ID PO24350

Purchase Order Date 5/26/2014

PO Print Date 5/26/2014

Page Number 1 of 4

m1294

Order From :

VC-TPI001

Ship To : DART AEROSPACE LTD

TPI INDUSTRIES INC.
148 RUE GOODFELLOW
DELSON, QUEBEC J5B 1V4
CANADA

1270 ABERDEEN
HAWKESBURY, ON K6A 1K7
CANADA

FAKED
C814/05/22

Contact Name

Vendor Phone

450-633-0484

Buyer

Customer POID

Customer Tax #

Terms

Currency

FOB

Chantal Lavoie

10127-2607

Net 30

CAD

Destination-Collect

Ship To Contact

Ship To Phone

Ship Via:

Day & Ross collect

Ship Acct:

Line Nbr	Reference Vendor Part Number Line Comments Delivery Comments	Description/ Mfg ID	Req Date/ Taxable Promise Date	CD	Req Qty/ Unit of Measure	PO Unit Price	Extend Pri
1	115815	D2432 BEARPAW	6/13/2014 Yes 6/13/2014		8.00 ✓	\$29.90	\$239.
	CUT BLANK AS PER FILE						
						Line Total:	\$239.
2	119506	D2432-3 BEARPAW	6/13/2014 Yes 6/13/2014		4.00 ✓	\$29.90	\$119.
	CUT BLANK AS PER FILE						
						Line Total:	\$119.
3	117114	D2435 BEARPAW	6/13/2014 Yes 6/13/2014		13.00 ✓	\$26.86	\$349.
	CUT BLANK AS PER FILE						

SP14-610

Note:

5/26/2014